



KV SPARVEN 17, HUS D KV SPARVEN 17, HUS E

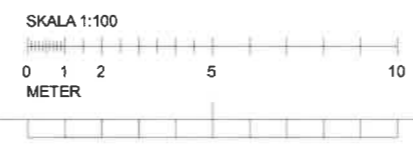

| BET | ANT | ÄNDRINGEN AV/SER | DATUM | SIGN |
|---|------------|------------------|------------|-------------|
| RELATIONSHANDLING | | | | |
| KV SPARVEN 17, Hus D STATIONSGATAN 27, LULEÅ | | | | |
| GALÄREN ARKITEKTER | | | | |
| TIRSÉN & AILI ARKITEKTER SMEDJEGATAN 17 97033 LULEÅ TEL 0920-203160 FAX 0920-203161 | | | | |
| K | | | | |
| V | | | | |
| E | | | | |
| M | | | | |
| | | | | |
| UPPDRAG NR | 5165.20-14 | RITAD/KONSTR AV | IHA/CSG | HANDLAGGARE |
| DATUM | 2014-03-26 | ANSVARIG | BENGT AILI | LWR |
| HUS D | | | | |
| VÅNING 2 (ENTRÉPLAN) | | | | |
| SKALA | A1 1:100 | NUMMÉR | A-04.1-02 | BET |
| | A3 1:200 | | | |

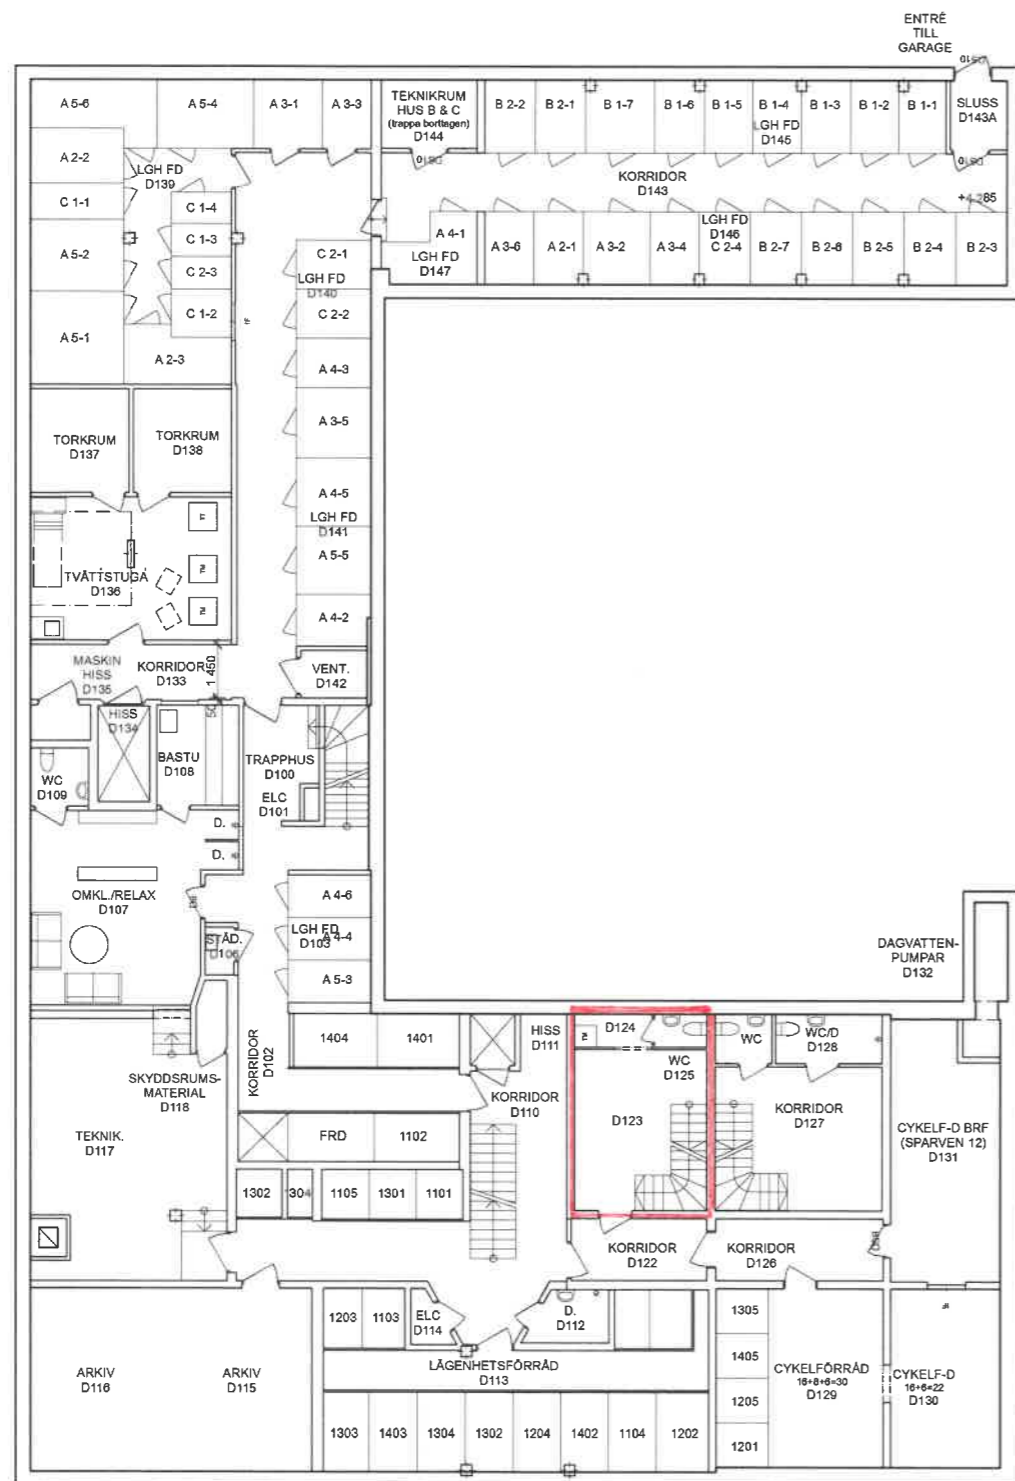

| BET | ANT | ÄNDRINGEN AVSER | DATUM | SKEN |
|---|------------|-----------------|------------|------------|
| RELATIONSHANDLING | | | | |
| KV SPARVEN 17, Hus D STATIONSGATAN 27, LULEÅ | | | | |
|  | | | | |
| TIRSÉN & AILI ARKITEKTER SMEDJEGATAN 17 97033 LULEÅ TEL 0920-203160 FAX 0920-203161 | | | | |
| K | | | | |
| V | | | | |
| E | | | | |
| M | | | | |
| I | | | | |
| | | | | |
| UPPDRAG NR | 5165.20-14 | RITADKONSTR AV | IHA/CSG | HANDLAGARE |
| DATUM | 2014-03-26 | ANSVARIG | BENGT AILI | LWR |
| HUS D | | | | |
| VÄNING 1 (Källare) | | | | |
| SKALA | A1 1:100 | NUMMER | A-04.1-01 | BET |
| | A3 1:200 | | | |